

SITE STATISTICS:

Civic address. 104-3993 Henning Dr. Burnaby B.C.


Legal Description. LOT 4 Plan LMS 3884. District lot 118 NewWestminster PID 024-510-939.

BUILDING DEPARTMENT

RECEIVED

JAN 14 2003

**BURNABY
FIRE DEPARTMENT**

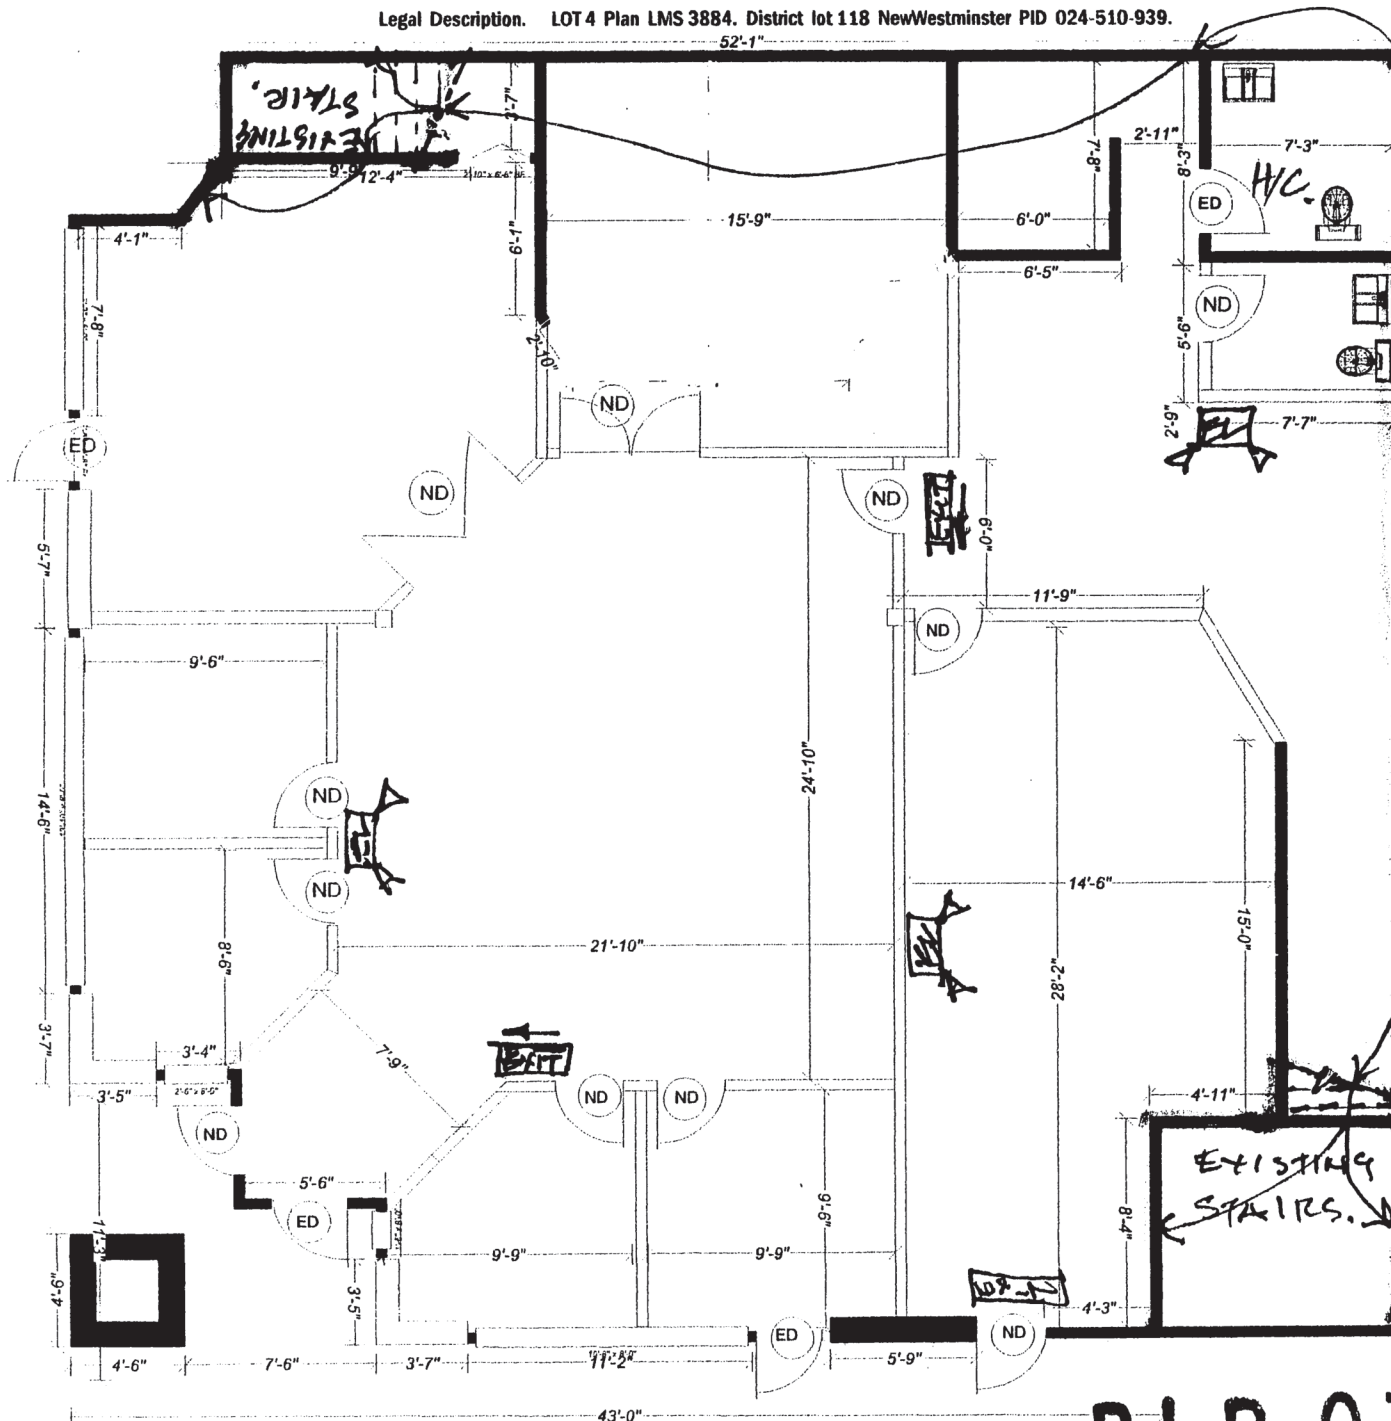

*3/4 HR. FIRE
SEPARATION TYP.*

**REVIEWED
CITY OF BURNABY**

Date **JAN 16 2003**

PLAN CHECKER

PER *[Signature]*

BLD 03 00035

SCALE: 1/8"=1'-00"

WOLL SCHEDULE