



#2129 - 11871 Horseshoe Way, Richmond, B.C.

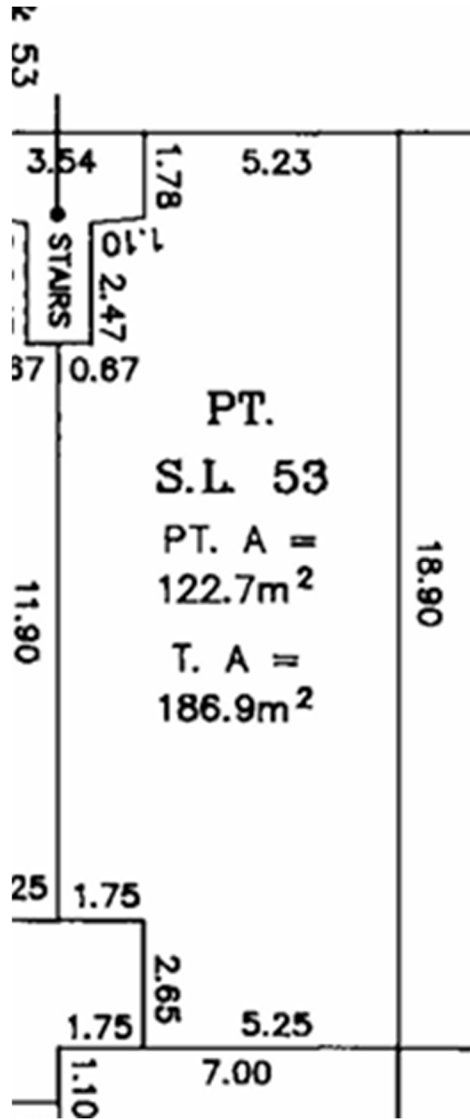

MAIN FLOOR

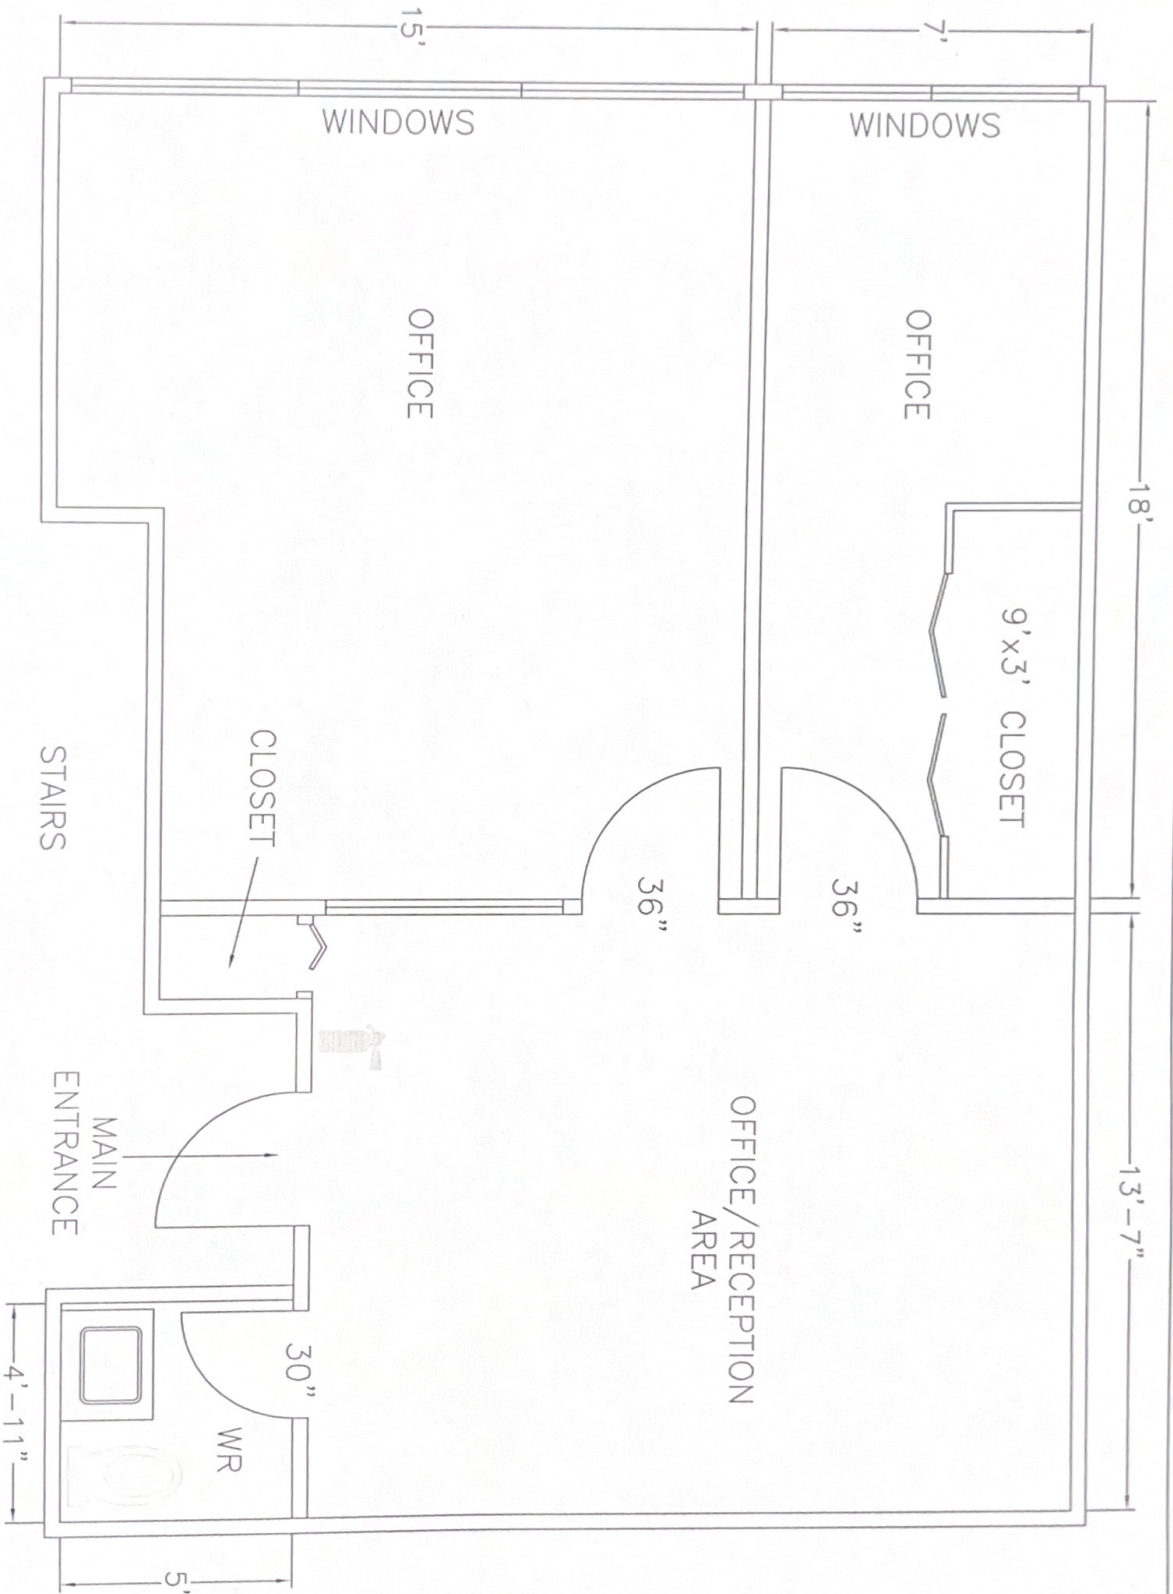

AS-BUILT FLOOR PLAN

Scale 1/4" = 1'

2129 - 11871 HORSESHOE WAY
 TOP FLOOR LAYOUT = 650 sq.ft
 RICHMOND BC